

TENDER SPECIFICATION

NO. CLW/ES/S - 25/~~A B C D E F G H~~
H

DRAWING NOS. :-

1. CLW/ES/SK-1/S- 25/~~A B C D E F G H~~
2. CLW/ES/SK-2/S- 25/~~A B C D E F G H~~
3. CLW/ES/SK-3/S- 25/~~A B C D E F G H~~
4. CLW/ES/SK-4/S- 25/~~A B C D E F G H~~
5. CLW/ES/SK-5/S- 25/~~A B C D E F G H~~
6. CLW/ES/SK-6/S- 25/~~A B C D E F G H~~
7. CLW/ES/SK-7/S- 25/~~A B C D E F G H~~
8. CLW/ES/SK-8/S- 25/~~A B C D E F G H~~
9. CLW/ES/SK-9/S- 25/~~A B C D E F G H~~

TOTAL NO. OF SHEETS & ALT. IN THIS SPECN.

SHEETS	12	15	15	16	16	20	20	20
ALT.	A	B	C	D	E	F	G	H I

**SPECIFICATION
FOR
CABLE TERMINALS & SLEEVES
25 kv. AC ELECTRIC LOCOMOTIVES
CLASS : WAG-7 & WAP-4/6**

ISSUED BY:

DY. CHIEF ELECTRICAL ENGINEER(D)
CHITTARANJAN LOCOMOTIVE WORKS
P.O.: CHITTARANJAN - 713331
DIST: BURDWAN, WEST BENGAL (INDIA)
DATE OF ISSUE:

NOTE:

THE SPECN. SUPERSEDES
EARLIER SPECN. NO. CLW/ES/S-9

SEE SHEET NO. 2

जांचा
CHKD
A

जांचित
DRN.
H. Mallik

SPECIFICATION
FOR
CABLE TERMINALS & SLEEVES

Anil
30.10.97
उप.मु.वि.ज. (जमि.)
DY. CEE.(D)

चित्तारंजन रेल इंजन कारखाना
पश्चिम बंगाल, भारत
CHITTARANJAN LOCOMOTIVE WORKS
WEST BENGAL, INDIA
क्रमांक/NO. CLW/ES/S-25/~~A B C D E F G H~~
दिनांक/DATE : 30-10-97 H I

DETAILS OF ALTERATIONS

ALT.NO.	DATE	DESCRIPTION	SIGNATURE	REMARKS
A	16-05-98	CONDUCTIVITY VALUE AMENDED IN CLAUSE NO. 4.2 & 4.3 AND TOLERANCES FOR J & B CHANGED IN SHEET 10 & 12.	<i>Arjib</i> 16.5.98	
B	24-10-98	SHEET NO. 13, 14 & 15 ADDED FOR THIN WALLED CABLE.	<i>Arjib</i> 22/11/98	
C	16-01-99	TERMINAL HOLE DIA OF TYPE-B 120 SQMM REDUCED TO 18MM FROM 21MM VIDE L. NO. ELDD/3212/ACG dt. 12-1-99.	<i>Arjib</i> 16.1.99	
D	13-10-99	SHEET 16 ADDED FOR 1.5 SQMM AND 'D' REVISED FOR TYPE 10 A IN SHEET 14.	<i>Arjib</i> 12-10-99	
E	06-03-01	SHEET NO. 13 & 14 MODIFIED FOR ADDITION OF 185 SQMM AND 240 SQMM CABLE TERMINALS for thin walled cables.	<i>Arjib</i> 6.3.01	<i>Sum</i> 6/3/201
F	11-03-02	SHEET NO. 17, 18, 19 & 20 ADDED FOR CABLE TERMINALS SIZE 2.5 & 300 SQMM FOR THIN WALLED CABLES	<i>Arjib</i> 11/3/02	<i>Arjib</i>
G	10-04-04	SHEET NO. 20 MODIFIED FOR INCORPORATION OF CABLE SLEEVE TYPE-23C FOR SL CONNECTION WITH 240 SQMM CABLE.	<i>Arjib</i>	<i>HC</i>
H	12.07.04	Dimension of 23C modified to suit existing SL clamp & 240 sq. mm. thin walled cable	<i>Arjib</i> 12/7	<i>HC</i>
I	21.04.14	Cable Terminal of Type-16B in sheet no. 17 has been included.	<i>Arjib</i> 21.4.14	<i>Arjib</i> 21/4/14 Vide approval of Note No. ELDD/3221, dt. 16.4.14 by CEB/LOLO.

SEE SHEET NO. 3

SPECIFICATION FOR

CABLE TERMINALS & SLEEVES

Arjib
30.10.97

उप.मु.वि.ज. (अभि.)
DY. CEE.(D)


वित्तरंजन रेल इंजन कारखाना
पश्चिम बंगाल, भारत

CHITTARANJAN LOCOMOTIVE WORKS
WEST BENGAL, INDIA

क्रमांक/NO. CLW/ES/S-25/ABCDEF
दिनांक/DATE: 30-10-97 8/1

संज्ञा
CHKD
Arjib

जारीकर्ता
DRN.
H. Maitra

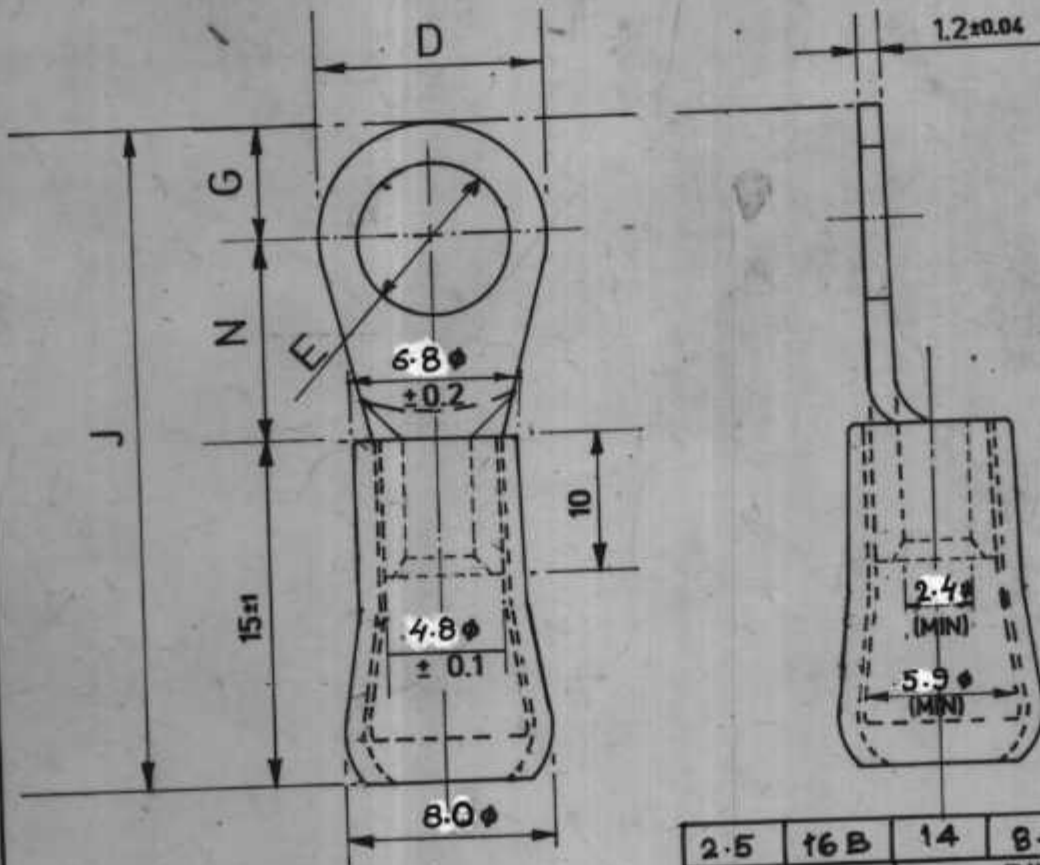

CABLE TERMINALS

TYPE-^{16B} 17B, 18B, 19B & 20B

FOR THIN WALLED CABLES

NOTE:

1 ALL DIMENSIONS ARE IN MM

2. THE CABLE TERMINAL SHALL BE MANUFACTURED OUT OF FULLY ANNEALED ELECTROLYTIC COPPER SHEETS & ELECTRO-TINNED AFTER FORMATION.

3. PVC YELLOW NON-INFLAMABLE SLEEVE (WITH COPPER SLEEVE REINFORCEMENT) SHALL BE PROVIDED AS PRE-INSULATION.

4. BRAZING BY SILVER ALLOY TO IS:2927 BA CUP 5 ON THE CUT.

5. ELECTROLYTIC COPPER SLEEVE (UNTINNED/TINNED) OF NOMINAL THICKNESS OF 0.25±0.05MM. SHALL BE PROVIDED INSIDE PVC SLEEVE.

6. THE TENDERERS SHALL RECOMMEND SUITABLE CRIMPING TOOL FOR CRIMPING CABLE CORE & INSULATION IN ONE OPERATION (FOR DETAILS OF CABLES SEE NOTE NO. 9).

7. TOLERANCE ON DIMENSIONS WHERE EVER NOT SPECIFIED SHALL BE CONSIDERED AS ±0.5.

8. PVC SLEEVE SHALL NOT DEVELOP CRACKS DURING CRIMPING AND AFTER SIMULATING AGEING TEST.

9. THE CABLE TERMINAL SHALL BE USED FOR CRIMPING ON 3 mm² ELASTOMERIC CABLES (CONDUCTOR DIA. 2.4±0.2 OVERALL DIA. ON INSULATION 5.5±0.5).

SIZE mm ²	TYPE	DIMENSIONS				
		D	E +0.1 -0	G ± 0.2	J ± 2	N
2.5	16B	14	8.2	7	33	11
2.5	17B	10	6.2	5	29	9
2.5	18B	8	5.2	4	26	7
2.5	19B	8	4.2	4	26	7
2.5	20B	7	3.2	3	26	8

SEE SHEET NO.18

SPECIFICATION FOR CABLE TERMINALS & SLEEVES

उप.मु.वि.ज. (जमि.)
DY. CEE.(D)

चित्तारंजन रेल इंजन कारखाना
पश्चिम बंगाल, भारत
CHITTARANJAN LOCOMOTIVE WORKS
WEST BENGAL, INDIA

क्रमांक/NO. CLW/ES/SK-5/S-25/FGH/I
दिनांक/DATE : 11-03-02

माँवा
CHKO

पारंपरिक
DRN.

TENDER SPECIFICATION

NO. CLW/ES/TS - 25/8/EC 2/88
H

DRAWING NOS. :-

1. CLW/ES/TS-25/8/EC 2/88A
2. CLW/ES/TS-25/8/EC 2/88B
3. CLW/ES/TS-25/8/EC 2/88C
4. CLW/ES/TS-25/8/EC 2/88D
5. CLW/ES/TS-25/8/EC 2/88E
6. CLW/ES/TS-25/8/EC 2/88F
7. CLW/ES/TS-25/8/EC 2/88G
8. CLW/ES/TS-25/8/EC 2/88H
9. CLW/ES/TS-25/8/EC 2/88I

TOTAL NO. OF SHEETS & ALT. IN THIS SPEC.

SHEETS	12	13	14	15	16	17	18
ALT.	A	B	C	D	E	F	G

**SPECIFICATION
FOR
CABLE TERMINALS & SLEEVES
25 KV. AC ELECTRIC LOCOMOTIVES
CLASS : WAG-7 & WAP-4/6**

EDITED BY:

BY: CHIEF ELECTRICAL ENGINEER
CHITTARANJAN LOCOMOTIVE WORKS
P.O. CHITTARANJAN - 700021
POST - BURDWAN, WEST BENGAL, (INDIA)
DATE OF ISSUE:

NOTE:

THE SPECN. SUPERSEDES
EARLIER SPECN. NO. CLW/ES/TS-2

TEL. NO. 211.1

SPECIFICATION

FOR

CABLE TERMINALS & SLEEVES

PREPARED BY (S/N)
OF: GEL/20

PREPARED BY (S/N) 2001/2001
CHITTARANJAN LOCOMOTIVE WORKS
WEST BENGAL, INDIA
DRAWING NO. CLW/ES/TS-25/8/EC 2/88
DATE: 30-10-87 H

REVISIONS

DETAILS OF ALTERATIONS

ALT. NO.	DATE	DESCRIPTION	SIGNATURE	REMARKS
A	26-02-38	CONDUCTIVITY VALUE AMENDED IN SLEEVE NO. 4-2 & 4-3 AND TIE-RINGS FOR 2 & 3 CHANGED IN SHEET 10 & 12	<i>Am</i> 12-1-38	
B	24-10-35	SHEET NO. 12, 13 & 14 ADDED FOR THIN WALLED CABLE	<i>Am</i> 12-1-38	
C	16-01-33	TERMINAL HOLE DIA OF TYPE B 13000MM REDUCED TO 10MM AND 12.5MM HOLE - 10 & 1200 2512/ACB dt. 12-1-33	<i>Am</i> 12-1-33	
D	19-10-33	SHEETS ADDED FOR 1350MM AND 10' REMOVED FOR TYPE 10A IN SHEET 14	<i>Am</i> 12-1-33	
E	26-12-35	SHEET NO. 12 & 14 MODIFIED FOR ADDITION OF 105 00MM AND 140 00MM CABLE TERMINALS	<i>Am</i> 12-1-38	
F	11-02-32	SHEET NO. 12, 10, 13 & 10 ADDED FOR CABLE TERMINALS DIA 25.5MM 25MM FOR THIN WALLED CABLE	<i>Am</i> 12-1-38	
G	10-06-04	SHEET NO. 22 MODIFIED FOR INCORPORATION OF CABLE SLEEVE TYPE-23C FOR SL CONNECTION WITH 24000MM CABLE.	<i>Am</i> 12-1-38	
H	12-17-34	Dimension of 23C modified to suit existing SL clamp & 240 sq. mm. thin walled cable	<i>Am</i> 12-1-38	

SEE SHEET NO. 1

SPECIFICATION FOR

CABLE TERMINALS & SLEEVES

Am
12-1-38
BY G.B. (W) /
BY G.B. (D)

DESIGN BY (W) M. S. SINGH
CHITTARANJAN LOCOMOTIVE WORKS
WEST BENGAL, INDIA
WORK NO. CLW/55/5-2472C/1
ISSUE DATE: 30-10-57

1. TECHNICAL SPECIFICATION

- 1.1 This specification covers the manufacture and supply of "Crimping type" copper cable terminals of different sizes and shapes indicated in the drawing attached.
- 1.2 The cable terminals shall be made out of seamless high conductivity copper tubes with a minimum copper content and silver present to be counted as copper of 99.90% electrical conductivity of the annealed copper tubes shall not be less than 99.25% when expressed as a percentage of the standard value for a standard annealed copper of 100% conductivity, as laid down by I.S. The chemical composition of the copper tube shall conform to grade 99 of IS:191 of 1980/IS:197 of 1976.
- 1.3 The interior and exterior surfaces of the cable terminal shall be duly treated by electro-tinning process. The thickness of the plating shall be uniform and not less than 0.005mm. The quality of the plating shall be such as to withstand crimping without peeling off.
- 1.4 The faces on each side of the cable terminal shall be parallel and flat.
- 1.5 The manufacturer shall engrave/emboss/imprint or any other permanent identification marks as considered satisfactory, indicating their name, addresses and brand name. Type number of the terminal shall also be suitably marked.

2. STANDARD

The raw material used for the terminals shall conform to IS 1977 of 1979, specification for seamless high conductivity copper tube for electrical purposes, and IS:191 of 1980, specification for electrolytic copper and IS:197 specification for a copper strip for electrical purposes.

3. DRAWING

The following drawings are enclosed with this specification for each type of copper terminal proposed to be purchased. It may kindly be noted that all dimensions indicated in the drawing are in mm. IS:30:CSA/VA/SC-L/D-15 to CSA/VA/SC-d/p-21.

SPECIFICATION FOR
CABLE TERMINALS &
SLIPERS


BY: S. S. (S.S.)
BY: C.S. (C.S.)

Prepared by: S. S. S. S.
DRAWN BY: C.S. S. S.
OBTAINABLE FROM: TECHNICAL WORKS
WEST BENGAL, INDIA
SHEET NO: CSA/VA/SC-15
ISSUE DATE: 15-05-2000

4. WIP TEST

4.1 Chemical composition - Chemical composition of the grade of copper used for cable terminals will be analyzed in accordance with IS 480 - 1944 - methods of chemical analysis of copper.

4.2 Microtinal conductivity test - Electrical conductivity of copper terminals shall be measured using conductivity meter and the value should not be less than 97.2%MS electrical resistivity test as per clause 9.0 of IS:1977-1981.

4.3 Flattening and doubling over test - Flattening and doubling over test shall be carried out on tubular portion of the terminal in accordance with IS 1977 of 1976 clauses 12.1 & 12.2.

4.4 Bend test - Bend test on the palm of the terminal shall be carried out in accordance with appendix 1 of IS 4324.

4.5 Crimping test - Crimping test shall be carried out by crimping cable terminal on their proper size and terminal with proper crimping tool. After crimping there should not be any crack or porosity of the cable socket tubes. No flaring of the sides of the cable sockets should occur after crimping.

Crimping of joints shall be tested in accordance with IS 4579 IS.1 of 1978 for -

- measurement of initial resistance.
- temperature cycling.
- final resistance &
- tensile strength.

4.6 Quality of plating - adhesion test to examine proper quality of plating shall be carried out in the following manner :-

i) The sample shall be bent through an angle of 180° on a diameter equal to the thickness of the sample. The sample shall not show any evidence of non-adhesion as may be revealed by lifting of the tin flakes from the base metal.

ii) The sample shall be rubbed rapidly and forcefully for 15 sec. with a rough metal instrument like copper coil. The burrished wire shall then be ~~examined~~ visually inspected and there should not be any indication of the deposit becoming detached.

4.7 Visual examination - Conformity to drawing the various dimensions, workmanship and provision of manufacturer's name, etc. shall be checked.

QUALIFICATION FOR
CABLE OPERATORS &
SLIVERS

me
T. S. R. S. (M.)
DY. GEN. (S)

Refer to 2' x 4' system
4000/200/200
CHITRAKALAN LOCOMOTIVE WORKS
WEST BENGAL, INDIA
WPT/NO. 216/85/0-25
ISSUE DATE: 15/05/2006

DATE
TIME

4.3 Sampling for type test

4.3.1 Suppliers who have not supplied any cable terminals in one case to CEM shall submit at least 30 percentage samples of each type for 10m, 15m & 20m terminals and 5 samples for all other type of terminals.

4.3.2 All tests as detailed above in clause 4.1. to 4.7 shall be carried out on these samples and their conformity as specified limits shall be checked up.

4.3.3 Improvements suggested after inspection and tests, shall be incorporated by the manufacturer in the bulk supplies without affecting guaranteed performance or any other terms and conditions of the contract.

4.3.4 Manufacturer shall not go ahead with the manufacture of bulk production unless prototype has been formally approved by CEM.

4.3.5 The supplier shall provide required testing facilities at their factory premises for conducting necessary tests as per relevant standard specification.

5. Quality Inspection

5.1 The sampling and criteria for conformity shall be as ISIRI, 1983 & IS-1977 of 1978.

5.2 The samples as picked up as detailed in clause 5.1 above shall be subjected to tests as stipulated in clause 4.7 above.

5.3 In addition to few samples from each lot or a part thereof, shall be picked up on random basis and subjected to tests stipulated in clause 4.1, 4.4 and 4.6.

6. Special Instructions to the supplier

6.1 The supplier shall furnish complete dimensional drawing for the cable terminals along with relevant materials specification.

6.2 The supplier shall also recommend suitable make and type of crimping tool for satisfactory performance of crimping of the terminals to meet the requirements of crimping test as laid down in clause 4.2.

6.3 The supplier shall provide a satisfactory evidence acceptable to CEM to the effect.

000-6

APPROVED BY: [Signature] DATE: [Blank]

Spec. for Cable Terminals & Sleeves

[Signature]

Revised by (as noted)

CHITTARANJAN LOCOMOTIVE WORKS
4001 BRIND, KOLKA

214/12 (10/1)
BY CEM (D)

WWS/NO. CLA/CR/S-05
Rev/DATE: 10-05-2000

a). He is a licensed manufacturer who regularly manufactures the item offered and has adequate technical knowledge and practical experience.

b). He has adequate financial establishment and means to meet the obligations under the contract for which he is required to submit a cheque from a recognized bank or financial institution.

c). He has adequate plant and machinery with the capacity to manufacture and supply the items offered within the delivery schedule offered by him.

d). He has established quality control systems and organization to ensure that there is adequate control of all stages of manufacturing process.

In addition to the above, further information regarding his capacity/feasibility, if required by GEM, shall be promptly furnished.

Tenderers not submitting to requisite information may hold that their offer is liable to be ignored.

WARRANTY

Material shall be guaranteed for 12 months from the date of commissioning or 10 months from the date of receipt whichever satisfactory performance. Run to design defect, but workmanship and faulty materials, etc. shall be excluded or ~~excluded~~, free of cost by the supplier.


GEM reserves the right to purchase material ~~from~~ any other certified firm.

Specn. For
Cable Terminal &
Circuit

[Signature]
BY GEM (G)

Prepared by GEM (GEM)
OFFICE OF
CHITTARANJAN LOCOMOTION WORKS
WEST BENGAL, INDIA
SERIAL NO. C/L/32/S-15
ISSUE DATE: 15-05-2006

16
 SHEET
 15/05/06
 C/L/32/S-15
 15/05/06

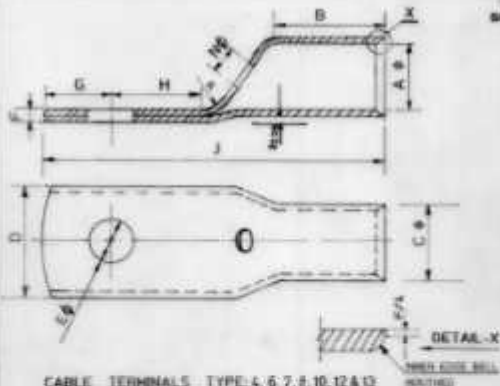

CABLE TERMINALS TYPE: 4, 6, 7, 8, 10, 12 & 13

NOTE: DIMENSION & THICKNESS GREATER THAN 12

		DIMENSIONS IN MM.									
SIZE	TYPE	A	B	C	D	E	F	G	H	J	K
80	4	22	41	28	162	18	8	18	25	188	1
100	6	18	35	24	162	18	8	18	25	188	1
120	7	17	30	22.2	12	14	5.2	18	27	188	1
150	8	17	30	22.2	12	14	5.2	18	27	188	1
20	10	18.8	26	14	20.2	11	1.2	14	20	100	2
25	12	18	20	12	17.5	8.2	2.4	14	21	100	2
25	13	8	18	10	15.2	8.2	2	10	14	100	2


NO. SHEET NO. 8

SPECIFICATION FOR CABLE
TERMINALS & SLEEVES


DR. CEE (0)

DESIGNED BY: DR. CEE (0)
CHITTARANJAN LOCOMOTIVE WORKS
WEST BENGAL, INDIA

DRAWING NO. CLW/ES/PSK/US-2/1001
[SIGN/DATE] 20/10/11

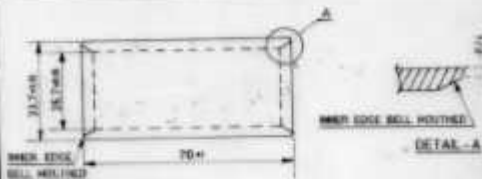

CABLE SLEEVE FOR TERMINALS OF TRACTION MOTOR, TYPE - 23A.

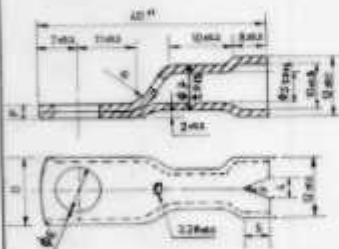

TYPE	1	2	3
14	Ø	1.2	2.0
15	U	1.2	1.5
16	S	0.7	1.4

CABLE TERMINALS TYPE - 14, 15 & 16 (10mm²)

NOTE: DIMENSION B SHOULD BE GREATER THAN 32

SEE DETAIL NO 1


SPECIFICATION FOR CABLE TERMINALS & SLEEVES

DR. G. S. (M/S)
DY. CEE (O)

DESIGNED BY: G. S. K. SINGH
1988 (M/S) 400
DUTTARAJAN LOCOMOTIVE WORKS
WEST BENGAL, INDIA

W/H/NO. CLW/CS/SM-2/3-25
REV/DATE: 2/11/11-11 2/6/11

REVISED
DATE: 2/11/11

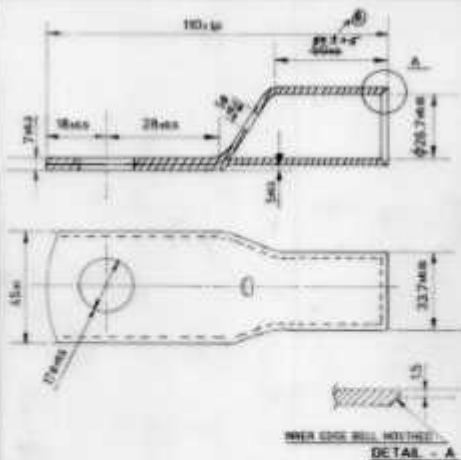

CABLE TERMINAL TYPE - 22 (300 mm²)

SIL 0001 NO. 01


SPECIFICATION FOR CABLE
TERMINALS & SLEEVES

BY: *[Signature]*
DY. CEE (D)

Prepared by: *[Signature]*
CHITTARANJAN LOCOMOTIVE WORKS
WEST BENGAL, INDIA

Drawn/NO. CLW/ES/SA-4/5-25/18/2018
Date: 20-11-18

BY: *[Signature]*
DY. CEE (D)

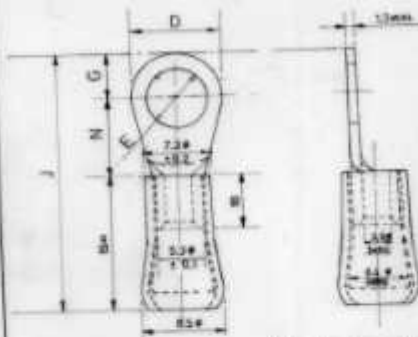

CABLE TERMINALS
TYPE- 17A, 18A, 19A & 20A

NOTE

1. ALL DIMENSIONS ARE IN MM

2. THE CABLE TERMINAL SHALL BE MANUFACTURED OUT OF FULLY ANNEALED ELECTROLYTIC COPPER SHEETS & ELECTRO-TIMED AFTER FORMATION.

3. PVC YELLOW NON-FLAMMABLE SLEEVE (WITH COPPER SLEEVE NON-FITMENT) SHALL BE PROVIDED AS THE INSULATION.

4. BRAZING BY SILVER ALLOY TO FITSHEET DA. CUP 3 ON THE OUT.

5. ELECTROLYTIC COPPER SLEEVE ANTIMONY/TANNED OF REMAIN THICKNESS OF 0.25mm SHALL BE PROVIDED INSIDE PVC SLEEVE.

6. THE TENDERMENT SHALL RECOMMEND SUITABLE CHIPPING TOOL FOR CHIPPING CABLE CORE & INSULATION IN THE OPERATION FOR DETAILS OF CABLES SEE NOTE NO. 3.

7. TOLERANCES ON DIMENSIONS WHERE EVER NOT SPECIFIED SHALL BE COMPLIED AS FOL.

8. PVC SLEEVE SHALL NOT DEVELOP TRACIS DURING CHIPPING AND AFTER SWEATING ALONG TEST.

9. THE CABLE TERMINAL SHALL BE USED FOR CHIPPING ON 3 mm GLASSFIBRE CABLES CONDUCTOR DIA 21.42 OVERALL DIA. ON INSULATION 15mm.

SEE SHEET NO. 10



SIZE mm ²	TYPE	DIMENSIONS				
		D	E ±0.1	G ±0.05	J ±0.1	K
3	17A	10	6.2	5	28	9
3	18A	8	5.2	4	26	7
3	19A	8	6.2	4	26	7
3	20A	7	5.2	3	26	6

SPECIFICATION FOR CABLE
TERMINALS & SLEEVES

REV. 01
31
(Sg/No. (X/R))
DY. CEE (D)

DESIGN BY (Sg/No. (X/R))
DETARANJAN LOCOMOTIVE WORKS
WEST BANGAL, INDIA
DRAWING NO. CLW/ES/SK-015-25/97
TPO/DATE: 30-10-97 Bn

REVISIONS
DATE
BY

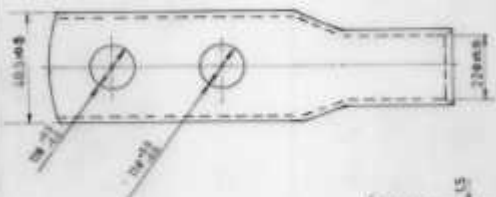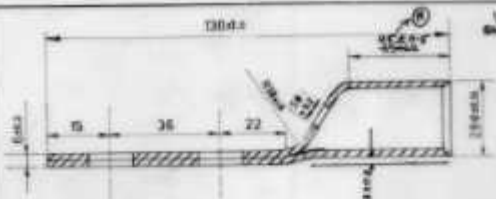

CABLE TERMINAL TYPE - 5/225mm²
FOR T. M. JOINT BOX

NOTE:

TOLERANCE ON DIMENSIONS UNLESS OTHERWISE SPECIFIED WILL
BE ±0.1 mm

SEE SHEET No. 13



SPECIFICATION FOR CABLE
TERMINALS & SLEEVES

Handwritten signature
BY: CEE/D

Drawn by: JEE MOHINI
Checked by: JEE
DUTTARAJAN LOCOMOTIVE WORKS
WEST BENGAL, INDIA
Drawing NO. CLW/ES/SK-5/S-25/100
Date: 30-10-97

DATE: 30-10-97
BY: CEE/D

REVISED
DATE

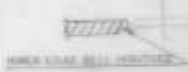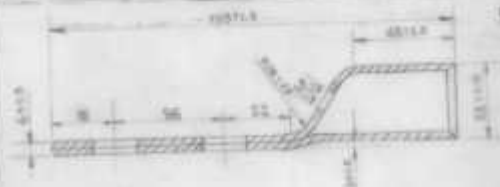

CABLE TERMINAL TYPE - SAJBS-wm?
FOR T.M. JOINT BOX


DESIGNED BY DRAWING GROUP ENGINEER OFFICE WFO
02-131.00

REVISED
DATE

INSTRUCTIONS FOR CABLE
INSTALLATION & SERVICE
FOR THIS WELDED CABLE

WFO
02/14/78
BY: CDE (O)

Ready to get more
CATERPILLAR LOCOMOTIVE WORKS
WEST BORDEN, ALA.
ATTENTION: WFO
REVISE DATE: 02-13-78

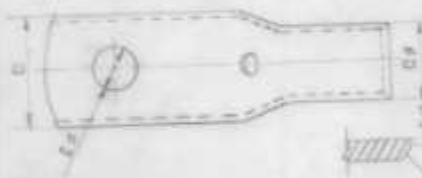

CABLE TERMINALS TYPE GA, 3B, 5A, 10A, 2/3A

NOTE: DIMENSION B SHOULD BE DELETED FROM 2/3A.




DIMENSIONS IN MM											
Code	GA	3B	5A	10A	2/3A	2	3	5	10	20	30
100	100	120	130	160	180	150	100	100	100	100	100
120	120	140	150	180	200	160	110	110	110	110	110
150	150	170	180	210	230	180	120	120	120	120	120
200	200	220	230	260	280	200	130	130	130	130	130
250	250	270	280	310	330	220	140	140	140	140	140
300	300	320	330	360	380	240	150	150	150	150	150
350	350	370	380	410	430	260	160	160	160	160	160
400	400	420	430	460	480	280	170	170	170	170	170

100
 120
 150
 200
 250
 300
 350
 400

SPECIFICATION FOR CABLE
 TERMINALS & DEVICES
 FOR THE WINDING CHILL

100
 120
 150
 200
 250
 300
 350
 400

DESIGN IN THE WORKS
 1000 1000 1000
 CHITTARANJAN LOCOMOTION WORKS
 1000 1000 1000
 1000 1000 1000 1000 1000 1000
 1000 1000 1000 1000 1000 1000
 1000 1000 1000 1000 1000 1000

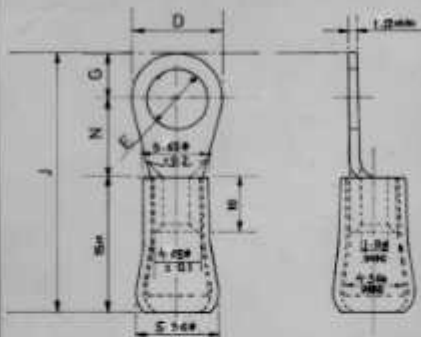

CABLE TERMINALS

TYPE-11A

SIZE mm ²	TYPE	DIMENSIONS				
		D	E ±0.05	S ±0.02	J ±0.05	N
1.5	11A	7	3.2	3	26	3

NOTE



1. ALL DIMENSIONS ARE IN MM.
2. THE CABLE TERMINAL SHALL BE MANUFACTURED OUT OF FULLY ANNEALED (ELECTROLYTIC COPPER SHEETS & ELECTRO-TINNED AFTER FORMATION).
3. PVC YELLOW NON-FLAMMABLE SLEEVE (WITH COPPER SLEEVE REINFORCEMENT) SHALL BE PROVIDED AS PRE-INSULATION.
4. BRAZING BY SILVER ALLOY TO SOLDER BA COP-3 ON THE END.
5. ELECTROLYTIC COPPER SLEEVE DURATION/THICKNESS OF NOMINAL THICKNESS OF 0.05mm SHALL BE PROVIDED INSIDE PVC SLEEVE.
6. THE TENDERERS SHALL RECOMMEND SUITABLE CRIMPING TOOL FOR CRIMPING CABLE CORE & INSULATION IN ONE OPERATION FOR DETAILS OF CABLES SEE NOTE NO. 51.
7. TOLERANCE ON DIMENSIONS WHERE EVER NOT SPECIFIED SHALL BE CONSIDERED AS IS.
8. PVC SLEEVE SHALL NOT DEVELOP CRACKS DURING CRIMPING AND AFTER SIMULATING AGING TEST.
9. THE CABLE TERMINAL SHALL BE USED FOR CRIMPING ON 1.2mm ELASTOMERIC CABLE CONDUCTION DIA. 6mm OVERALL DIA. ON INSULATION 4.5mm.

SEE SHEET 001

SPECIFICATION FOR CABLE TERMINALS & SLEEVES

DR. N. N. (N. N.)
DY. CEE, (0)

Drawn by: JAY SHANKAR
CHITTARANJAN LOCOMOTIVE WORKS
WEST BENGAL, INDIA
WORK NO. CLW/ES/SR/10/5-25/1/ERS
DATE: 15-10-93 H

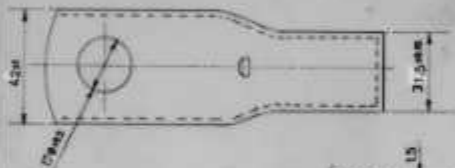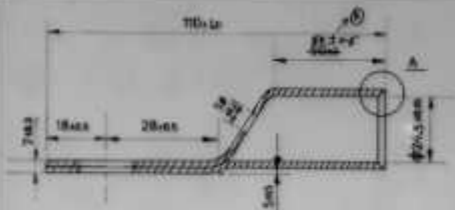

CABLE TERMINAL TYPE - 22B(300 mm²)
FOR THIN WALLED CABLES


SEE SHEET NO. 1-9

SPECIFICATION FOR CABLE
TERMINALS & SLEEVES

DR. J. N. K. (S.F.)
DY. CEE (D)

Refer to page number
1004 1005 1006
CHITTARANJAN LOCOMOTIVE WORKS
WEST BENGAL, INDIA
WORK NO. CLW/ES/SK-4/5-25/PJH
Drawn/DATE: 11-03-02

APPROVED
DATE

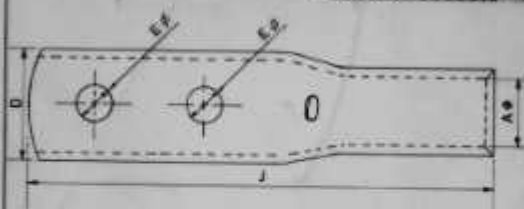

CABLE TERMINAL TYPE - 3 & 25A
FOR THIN WALLED CABLES

BELL MOUTH BELL MOUTHED
DETAIL - 'X'

SIZE mm ²	TYPE	DIMENSIONS IN MM												REMARKS
		A	B	F	G	H	I	J	K	L	M	N		
170	3	28	55	32	40	11	6	10	24	142	12	26	5	SEE NOTE 1 BELOW
300	25A	34.5	55	30.5	40	11	8	9	31	142	12	26	5	

NOTE:

1 DIMENSION B SHOULD BE GREATER THAN J

2 TYPE 25A OF 300 mm² IS ONLY FOR HTACH TRACTOR MOTOR & TYPE 3 OF 275 mm² IS ONLY FOR TAD 350 MOTOR.

SEE SHEET NO. 2/3

SPECIFICATION FOR CABLE
TERMINALS & SLEEVES

TEL: 9111 (4th.)
DY. CODE (0)

Drawn by: (SRI RAMAN)
BY: (SRI RAMAN)
CHITTARANJAN LOCOMOTIVE WORKS
PUNE BENGAL, INDIA
WORK NO: CLW/ES/PSK-3/5-20/854
REVISE DATE: 11-03-01

