



Draft copy of modified Dwg No. CWS/E3/3/SK-1/0132 for set of Cable Tray


POS-9

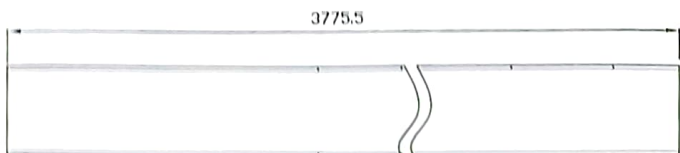


POS-10

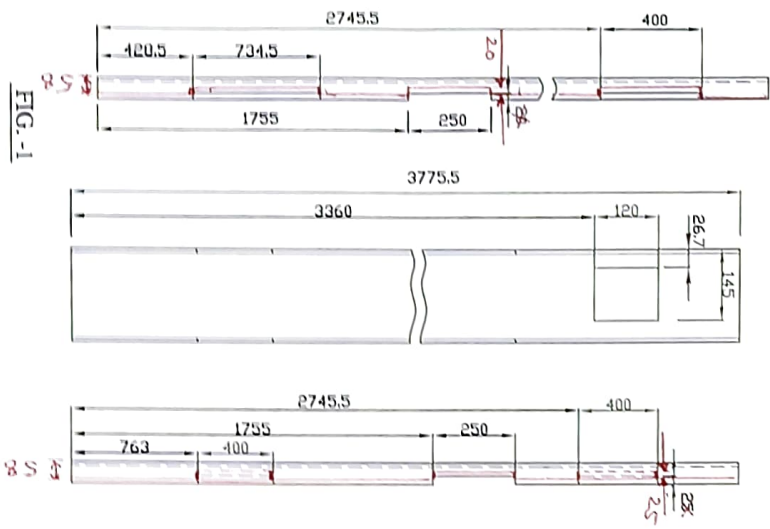


POS-7

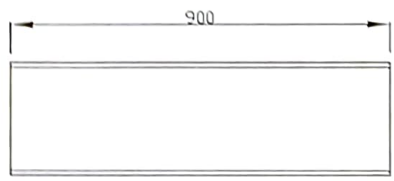

POS-8

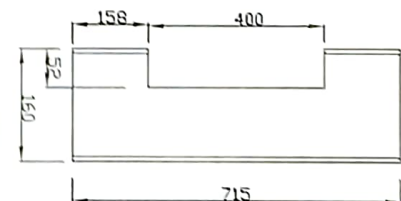

POS-11

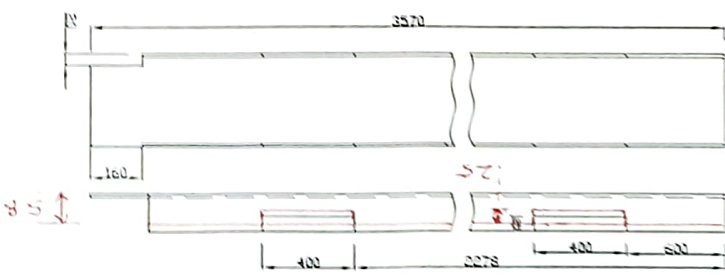

POS-12



FIG.-1

FIG.-1

FIG.-1

Note: (i) Height reduced from 65 mm to 58 mm, keeping all other dimensions are remain same.
(ii) modifications indicated in Red.

55/E/P/7