NOTES:-

1. FOR WIND SCREEN ASSLY. REFER TO DRG NO - 03/1/35/287.
2. FOR PROTECTION GRILL MOUNTING ARRGT: FOR FRONT GLASS REFER TO DRG NO - 03/2/38/94.
3. FOR FLASHER LIGHT ASSLY. REFER TO DRG NO - 05/1/35/161.
4. FOR MOUNTING ARRGT. OF CAB FAN REFER TO DRG NO - 03/1/38/20.
5. FOR BRACKET FOR AIR CONVECTOR REFER TO DRG NO - 03/3/35/352.
6. THIS DRG. IS TO BE FOLLOWED FOR AIR CONDITION LOCO ONLY.
7. EPOXY BASED ZINC PHOSPHATE PRIMER (TWO PACKS) AS PER PAGE 5,6,7&8 OF RDSO'S SPECN. NO - M&C/PCN/100/2006 TO BE APPLIED ON ASSEMBLY.
8. REF. NOS. 43 TO 48 TO BE USED FOR WAG-7 (A-C) LOCO ONLY. (REF. 48 LOOSE)
9. REF. NOS. 15 & 16 TO BE CUT TO SUIT ROOF PROFILE.

①	57	–	MAKE UP SHEET 1120 x 50 x 4 THK.	4	STEEL	IRS-M41	
①	56	–	STIFFENER. Ø6m·m x 796 LG.	2	STEEL	IS:2062 GR-A	
	55	1209-18-406-0750	3/4" SOCKET.	2	–	–	
	54	–	SUPPORT ANGLE TO IS:808 40x40x5 THK X 1018 LG.	2	STEEL	IS:2062 Fe 410 WA	
	53	–	COVER (LOOSE FOR TRADE SUPPLY)	2	STEEL	IRS-M41	
	52		PIPE CLAMP	8	STEEL	IRS-M41	
	51	–	DRAIN PIPE 25 NB x 4.5 MM	2	S/S	ASTM-A 269	
	50	CLW/ES/6K-2/A-15	TROUGH	2	–	–	
	49		TROUGH MOUNTING SHEET 600 LG x 47 THK	4	STEEL	IRS M-41	
②	–	48 05/4/35/148	CAB LAMP BRACKET (LOOSE FOR TRADE SUPPLY)	2	–	–	P349/287
–	–	47 05/4/33/12	BLEECH BLOCK	24	TEAK WOOD		P313/030
–	–	46 06/2/33/4	CASING FOR FAST COUPLERS	2	–	–	" /577
–	–	45 06/3/33/3	SPRING FASTENING BRACKET	2	–	–	/576
–	–	44 06/3/33/2	CASING FOR R.H. OUT GOING OF CABLE	2	–	–	/570
–	–	43 06/3/33/1	REST BOX SUPPORT	2	–	–	/569
②	R349/677	42 –	SPRING WASHER M 10B	4	STAINLESS STEEL	IS : 3063	" /568
②	R349/676	41 –	HEX HD. SCREW M 10 x 16 LG.	4	STEEL	IS:1364 3.8-8	" /567
②	R349/675	40 03/1/35/379 REF - 2	PLATE FOR WATER TANK 240 x 30 x 16 THK.	2	STEEL	IS: 2062 Fe-410 WC	" /566
②	R349/674	39 03/1/35/379 REF - 1	PLATE FOR WATER TANK 100 x 30 x 16 THK.	2	STEEL	IS: 2062 Fe-410 WC	" /565
	R349/647	38 182-00319-006	SCREW CSK SLOTED HD : M8 x 20 x 1.25 P	8	STAINLESS STEEL	–	" /441
	R349/646	37 182-00233-006	SCREW CSK SLOTED HD : M6 x 20 x 1 P	144	STAINLESS STEEL	–	" /440
②	R349/645	36 ~~109-00-233-019~~ 1209-09-133-018	STRIKING PLATE (CAB & LOCO ASSLY) (CAB SIDE DOOR)	4	–	–	" /439
②	R349/644	35 ~~109-00-133-021~~ 1251-01-133-018	DOOR LATCH ASSLY.	4	–	–	" /438
②	R349/643	34 ~~182-00236-004~~ 1209-11-133-031	INTER LOCK ASSLY CAB SIDE DOOR	4	–	–	" /437
	R349/642	33 182-00232-004	SCREW PHILIPS CSK HD. M5 x 12 x 0.8 P	218	STAINLESS STEEL	–	" /436
	R349/633	32 1209-09-133-006	CAB WINDOW R.H.	2	–	–	" /435
	R349/631	31 1209-09-133-005	CAB WINDOW L.H.	2	–	–	" /434
②	R349/631	30 1209-09-133-004	CAB ~~WINDOW~~ DOOR R.H.	2	–	–	" /433
②	R349/630	29 1209-09-133-003	CAB ~~WINDOW~~ DOOR L.H.	2	–	–	P349/432
②	R349/647 ~~623~~	28 03/4/35/365	WATER TRAY ANGLE BRACKET	2 L.H. 2 R.H.	–	–	" /562
	R349/626	27 03/4/35/364	WATER TRAY COVER PLATE	4	STEEL	IRS : M 41	" /561
	R349/625	26 03/4/35/363	BRACKET	4	STEEL	IRS : M 41	" /560
	R349/622	25 03/4/35/362	SUPPORT FRAME ASSLY	4	–	–	" /557
	R349/619	24 03/4/35/361	CORNER PIECE ASSLY (TOP)	4 L.H. 4 R.H.	–	–	" /554
	R349/616	23 03/4/35/360	CORNER PIECE ASSLY (BOTTOM)	4 L.H. 4 R.H.	–	–	" /551
	R349/615	22 03/4/35/359	ANGLE (VERTICAL)	4 L.H. 4 R.H.	–	–	" /550
	R349/614	21 03/4/35/358	ANGLE (TOP) (CAB SIDE DOOR)	4	–	–	" /549
	R349/613	20 03/4/35/357	BOTTOM ANGLE (CAB SIDE DOOR)	4	–	–	" /548
		19 –	CAB ROOFING PANEL SHEET (REAR RIGHT) 1082 x 404 x 3.15 THK.	2	STEEL	IRS: M41	
		18 03/1/35/294 (A-C)	HEAD LIGHT COVER ASSLY.	2	–	–	
		17 –	ROOF PANELING STRIP 60 X 1072 LG X 4 THK.	4	STEEL	IRS: M41	
		16 –	MAKE UP SHEET 60 X 1000 LG X 4 THK.	2-R.H. 2-L.H.	STEEL	IRS: M41	
		15 –	MAKE UP SHEET 60 X 4 THK. X 1126 LG.	2	STEEL	IRS: M41	
	R349/436	14 03/4/35/259	PANEL SHEET.	2	–	–	" /534
	R349/172	13 03/4/35/89	BOTTOM END MAKE UP SHEET	2 L.H. 2 R.H.	–	–	" /533
	R349/609	12 03/4/35/347	GUSSET PLATE FOR SIDE WINDOW.	4	–	–	" /532
	R349/608	11 03/4/35/346	MODIFIED CAB SIDE WALL.	4	–	–	" /531
	R349/176	10 03/4/35/91	RAIN GUTTER FOR FRONT GLASS.	2	–	–	" /528
	R349/509	9 03/1/35/343 (A-C) 06/1/35/188 (A-C)	FRONT PANEL SHEET ASSLY.	2	–	–	
	R349/508	8 03/4/35/349	END PROFILE PANEL SHEET	2	–	–	" /523
	R349/597	7 03/4/35/348	END PROFILE PANEL SHEET	2	–	–	" /522
		6 –	CAB ROOFING PANEL SHEET (REAR LEFT) 1082 x 464 x 3.15 THK.	2	STEEL	IRS: M41	
		5 03/4/35/305 (A-C)	CAB ROOFING PANEL SHEET	2	–	–	
	R349/145	4 03/4/35/77 REF - 2	CAB ROOFING PANEL SHEET	2	–	–	" /515
	R349/144	3 03/4/35/77 REF - 1	CAB ROOFING PANEL SHEET	2	–	–	" /514
	R349/141	2 03/4/35/76 REF - 2	CAB ROOFING PANEL SHEET	2	–	–	P349/513
	R349/140	1 03/4/35/76 REF - 1	CAB ROOFING PANEL SHEET	2	–	–	P349/512
	5/682		CAB OUTER PANELING ASSLY.	2	–	–	39/657
	CAD NO. WAP-4	REF. NO.	PART DRG. NO.	DESCRIPTION	QTY.	MATL	SPECN	CKD NO. WAG-7

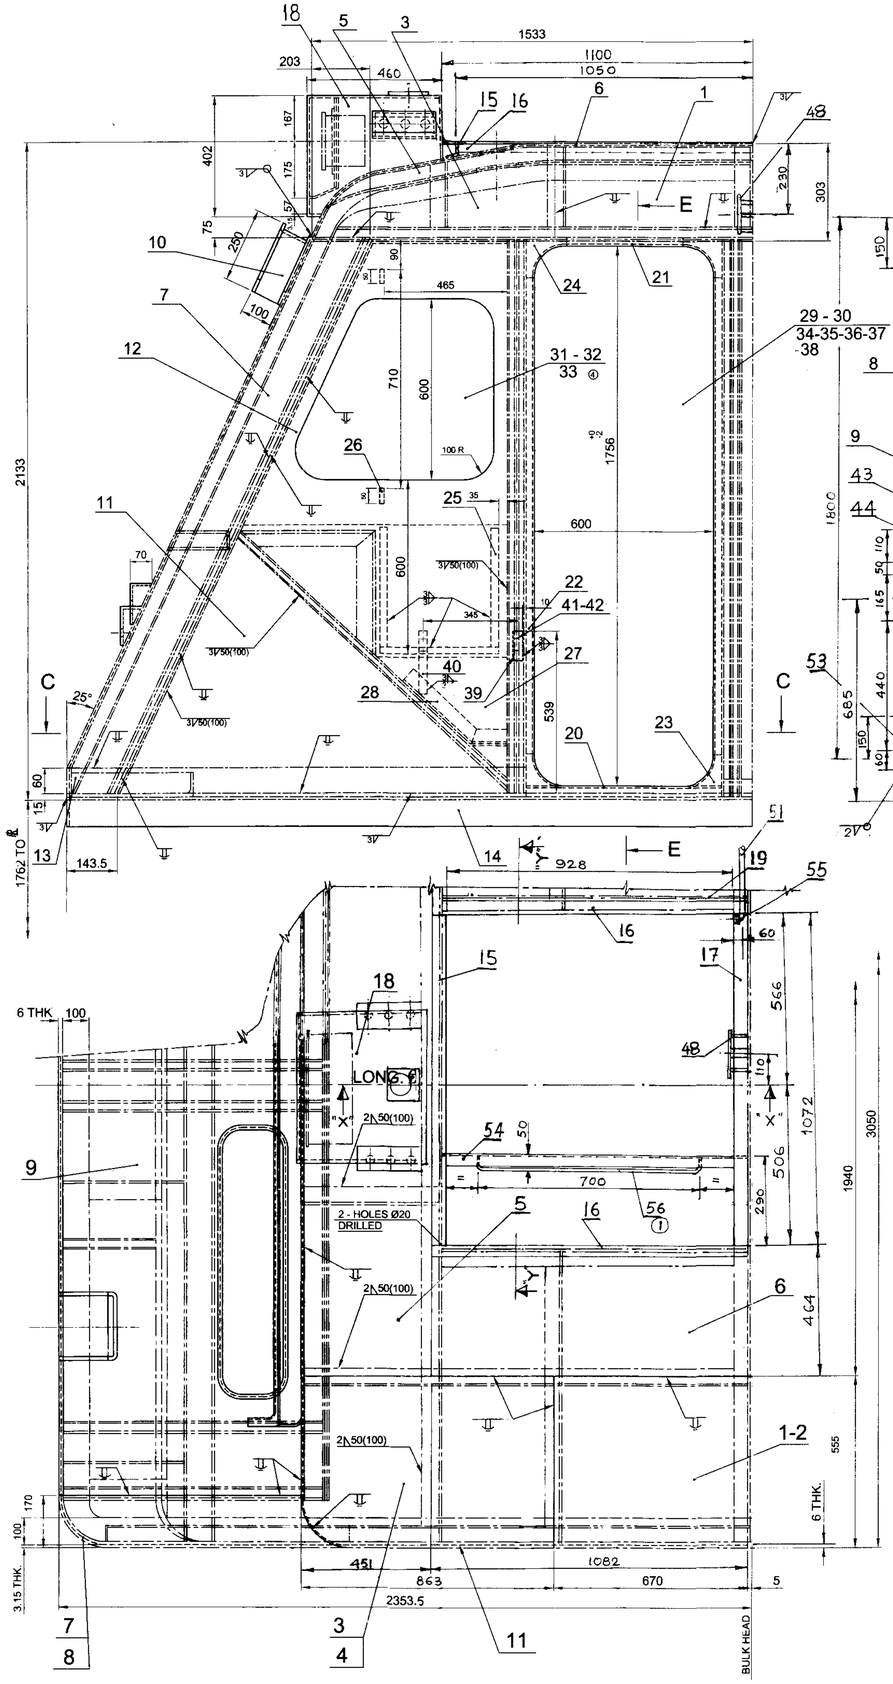

② 10. REF. NO. 29 TO 32, 34, 36, 38, 41, 42 NOT TO BE SUPPLIED BY FIRM.

② 11. DESCRIPTION OF REF. NO. 29, 30, 36 ; PART DRGS. NO. OF REF. NO. 34 TO 36 ; MATL. OF REF. NO. 42 ; C&D NO. OF REF. NO. 29 CORRECTED AND MATL. SPECN. OF REF. NO. 41 ADDED.

SCHEMATIC DIAGRAM SHOWING THE LOCATION OF FLASHER LIGHT

IS:3073

SURFACE ROUGHNESS VALLUE TO IS:3037	NUMBER	N1	N2	N3	N4	N5	N6	N7	N8	N9	N10	N11	N12
	Ra μm	0.25	0.05	0.1	0.2	0.4	0.8	1.6	3.2	6.3	12.5	25	50
	SYMBOL												

ALT. NO.	AUTHY	DESCRIPTION	DATED INITIAL
②	DY.CEE/D-I	AS PER CEE/LOCO APPROVAL NO. ELOD/2417/SUP. Dt. 11/7/2012 DRG. BROUGHT UP TO DATE AND NOTE 10 AND 11 ADDED.	
①	DY.CEE/D-I	REF. 56,57 ADDED, SECTION VIEW "X-X" & "Y-Y" MODIFIED.	

DRAWN	
CKD. BY	
S/ELDO (M)	
SME(D)	
DY CEE (D)	
DATE	20-11-10
SCALE	N.T.S.
APPROVAL REF. NO.	03/1/35/289

REFERENCE DRG. NO. 03/1/35/341 & 06/1/35/87

MODIFIED SPACIOUS CAB OUTER PANELLING ASSLY. FOR A-C LOCO

CHITTARANJAN LOCOMOTIVE WORKS

USED FOR LOCOS :- WAG-7, WAP-4

DRAWING NO. 03/1/35/341 (A-C)

② ①

Signature Not Verified
Digitally signed by SHIB NARAYAN KUNDU
Date: 2022.04.10 13:27:50 IST
Reason: IRES-CRIS
Location: New Delhi