NEXT ASS'Y ~~IA011-00066~~ ⚠1
~~IA011-00319~~
IA011-00317 ⚠2

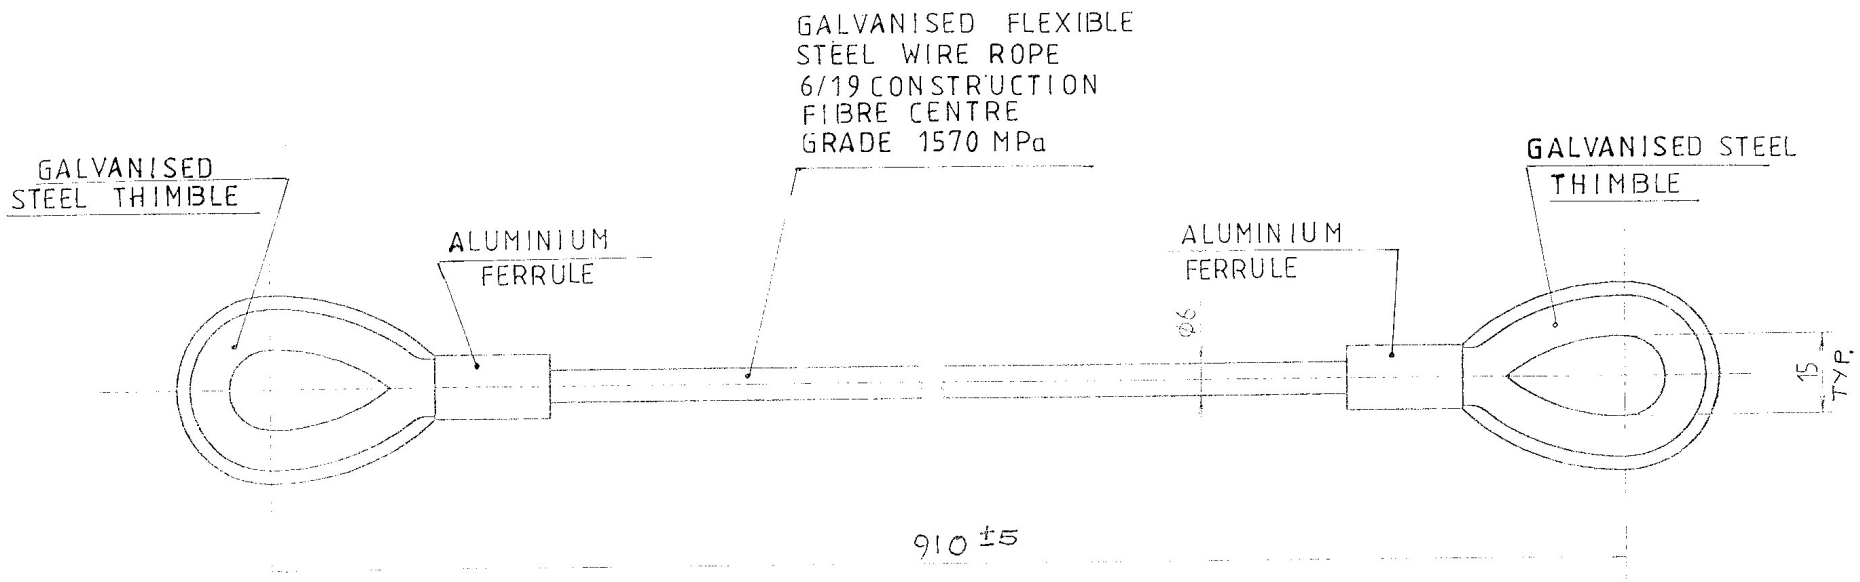

(TO BE INSTALLED AT No 1 &2 BOGIE CONNECTION END)

UNLESS OTHERWISE SPECIFIED
TOLERANCE ON ALL DIMENSIONS
OF LENGTH AND ANGLE TO
BE TO SPEC ES 1002
PAR B
TOLERANCES MUST NOT BE CUMULATIVE

ABB Transportation
1st ANGLE PROJECTION
ABB Drawing Title: FIXING CABLE
ABB Dwg No: IA016-00260
Sheet 1 of 1

DIN ISO 2768 m L
DIN 8570 BF
DIN 6930 g
DIN 6935
DIN 2310 II B
DIN 2310 II D

ID 1/85

2	ERN 16952 NEW NEXT ASSY 25.5.95 H.S		
1	ERN 10410 MODIFIED P.BANDE & NONO PROCEDURES	9.11.94	H.S.
	AMENDMENTS	Date	Name

IR Bo' Bo'

Scale 1:1 Weight ~0.2 kg
Material / Specification: (analogous to DIN 3088 PK - A6 x 1)

1994 Date Name
Drawn 18.04 Loader
Checked 28.04
Approved
Dept FEK 1
ABB Henschel AG

Title: Fixing cable
Drawing No: (667 - 155.01 - 12)
Sheet 01 of 01 Sh