TOTAL MASS (kg)	ALL DIMENSIONS IN mm UNLESS OTHERWISE SPECIFIED. SURFACE ROUGHNESS Ra VALUES IN μm.
0.33 kgs.	

DO NOT SCALE DRAWINGS, IF IN DOUBT ASK!

REMOVE ALL BURRS & SHARP EDGES

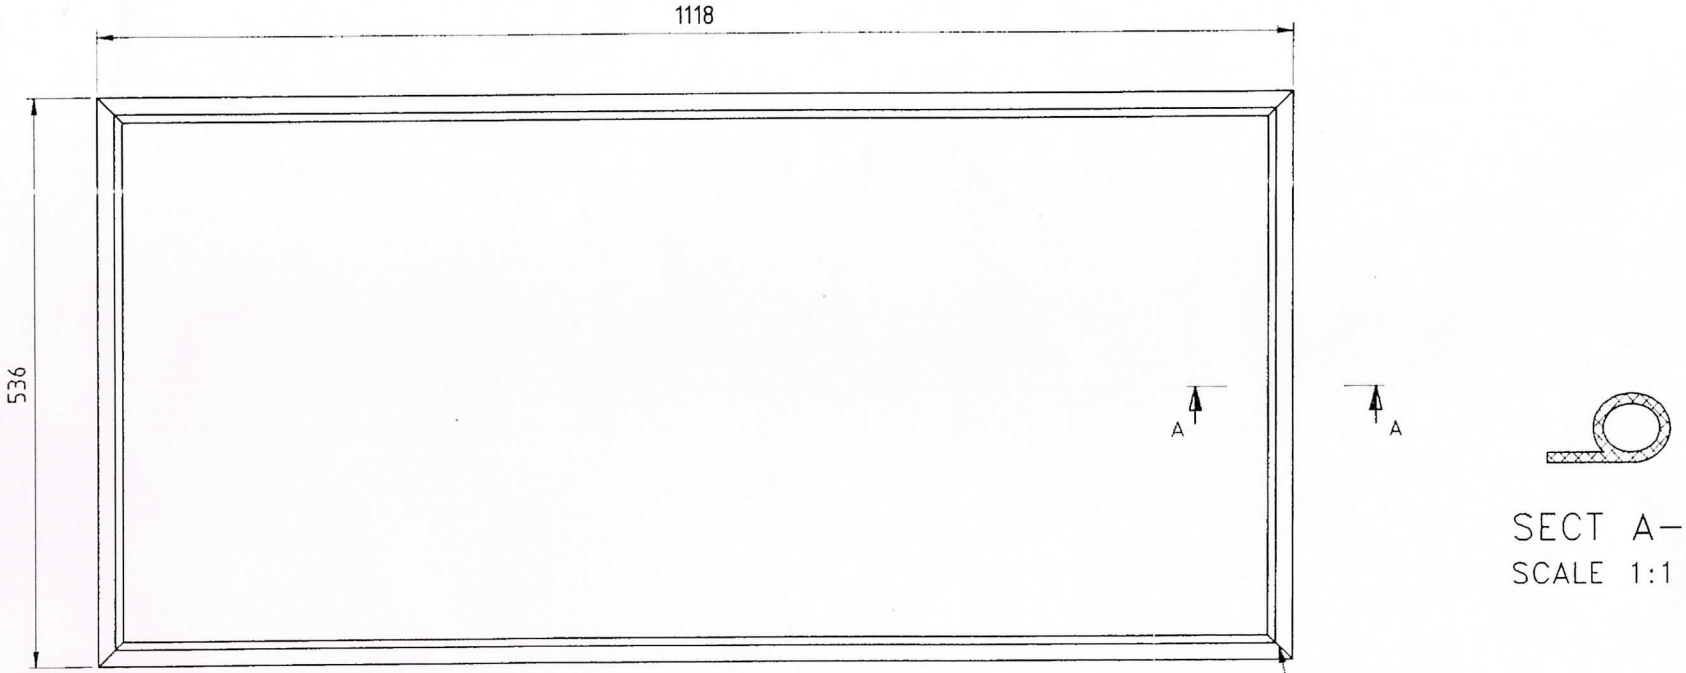

SECT A–A
SCALE 1:1

VULCANISED MITRE JOINTS
4 PLACES

MATERIAL E.P.D.M.
~~NARM RUBBER PRODUCTS SECTION RG46.~~

~~SUPPLIER~~ ~~NORTH AUSTRALIAN RUBBER MILLS LTD.~~
~~37 TIMMS RD. EVERTON HILLS QLD.~~

SPECIFICATION – (1) TENSILE STRENGTH = 150 kg/cm²
(2) DENSITY = 1.17 g/cm³, (3) COMP. SET = 25%
(4) ELONG. AT BREAK = 370%, (5) TEMP. RANGE = -40 to 120°C

~~TRANSFER OF TECHNICAL~~
~~ISSUE~~
~~31 DEC 1995~~

ITEM	PART NUMBER	QTY	MASS PER ITEM (kgs)	SOURCE	ITEM DESIGN	DESCRIPTION
15						
14						
Rev	Alteration	Y-MM-DD Initials	Ckd
0	ORIGINAL ISSUE		
1	ERN 11493 DIMS 1118 & 536 WERE 120 & 542, MAT'L WAS IA102-00183. CAN 487	95-03-30 R.S.	RR

TYPE OF TEST/REPORT	YES	NO
Test Certificate		
Test Results		
Material Certificate		
Initial Sample Inspection Report		

UNLESS OTHERWISE SPECIFIED, TOLERANCES ON ALL DIMENSIONS OF LENGTH & ANGLE TO BE TO SPEC. ES1002

PART B

TOLERANCES MUST NOT BE CUMULATIVE

NEXT ASSEMBLY No. IA061-00155

CONTRACT USED ON C875

Drawn by WAF YY-MM-DD 95-02-22

Checked

Approved by

Proj Eng RR

Prod Eng

Weld Eng

Eng

3rd ANGLE PROJECTION

Cad File No. C875\PRODN\06\6-00127

N.C. Machine Program No.

ABB Transportation Pty Limited
A.C.N. 010 699 804

Drawing Title SEAL-DOOR

(RED WORK)

Customer Dwg No.

ABB Dwg. No. IA066-00127 (R1)

Scale 1:5

Sheet 1 of 1

A3

...and by the value of international copyright conventions are reserved to ABB. Reproduction in whole or in part requires the prior written consent of ABB.

...the drawing incorporates confidential information of ABB, its disclosure to third parties also requires ABB's prior written consent.

...This document/drawing was prepared by or on behalf of ABB Transportation Pty Limited and the copyright therein belongs to ABB.